



C. Earl Hunter, Commissioner

Promoting and protecting the health of the public and the environment.

PUBLIC NOTICE AMENDMENT REQUEST

The permittee for **P/N# OCRM-05-243-R, Vincent Brown**, has requested an amendment to the issued permit. Specifically, the applicant proposes to increase the size of the existing fixed pierhead from 10' x 10' to 15' x 15' and add a roof and benches. The proposed amendment is for changes to a private recreational dock on and adjacent to the Atlantic Intracoastal Waterway at 3 Conquest Avenue, Sullivan's Island, Charleston County, South Carolina.

Written comments will be received on this amendment request until April 14, 2008. For further information please contact the project manager for this activity, Steven Brooks, 843-953-0235.

April 4, 2008

SOUTH CAROLINA DEPARTMENT OF HEALTH AND ENVIRONMENTAL CONTROL

Ocean and Coastal Resource Management

Charleston Office • 1362 McMillan Avenue, Suite 400 • Charleston, SC 29405

Phone: 843-953-0200 • Fax: 843-953-0201 • www.scdhec.gov

MONUMENTS USED:

USCOE MONUMENT

1276+32.45S 160' LT

N = 341705.320


E = 2348776.050

USCOE MONUMENT

1270+88.94S 160' LT

N = 341374.830

E = 2349207.500

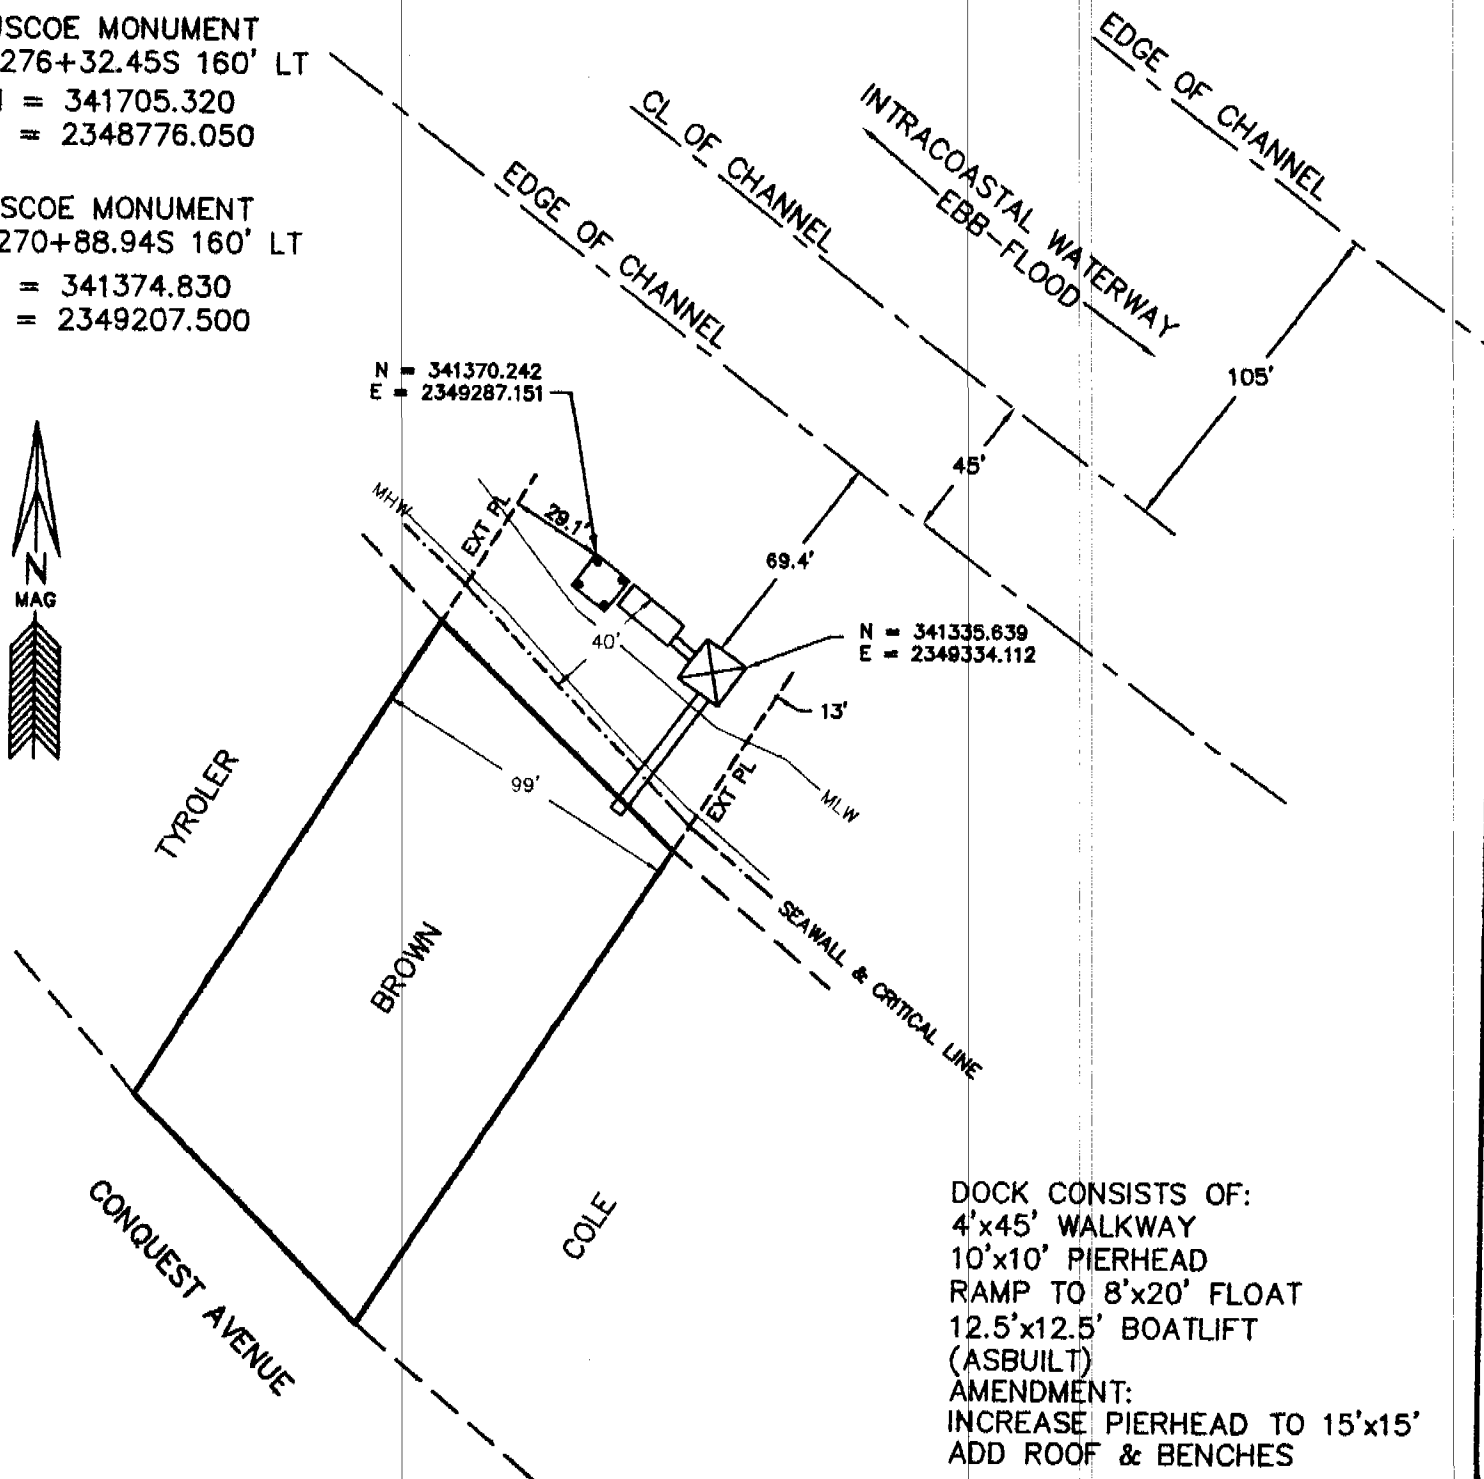

DOCK CONSISTS OF:

4'x45' WALKWAY

10'x10' PIERHEAD

RAMP TO 8'x20' FLOAT

12.5'x12.5' BOATLIFT

(ASBUILT)

AMENDMENT:

INCREASE PIERHEAD TO 15'x15'

ADD ROOF & BENCHES

OCRM-05-243-R

APPLICANT: VINCENT BROWN
#3 CONQUEST AVENUE
SULLIVANS ISLAND
CHARLESTON COUNTY
TMS#523-06-00-029
INTRACOASTAL WATERWAY


AMENDMENT
PRIVATE
RECREATIONAL
DOCK

DATE: MARCH 17, 2008


SCALE: 1" = 60'



60 0 60

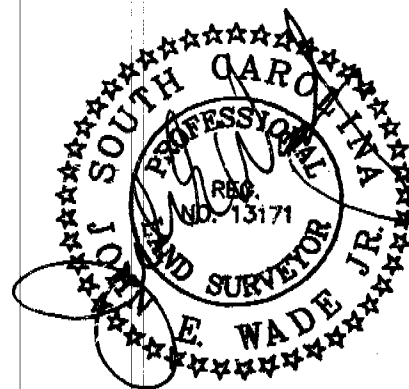

FILE #184-05

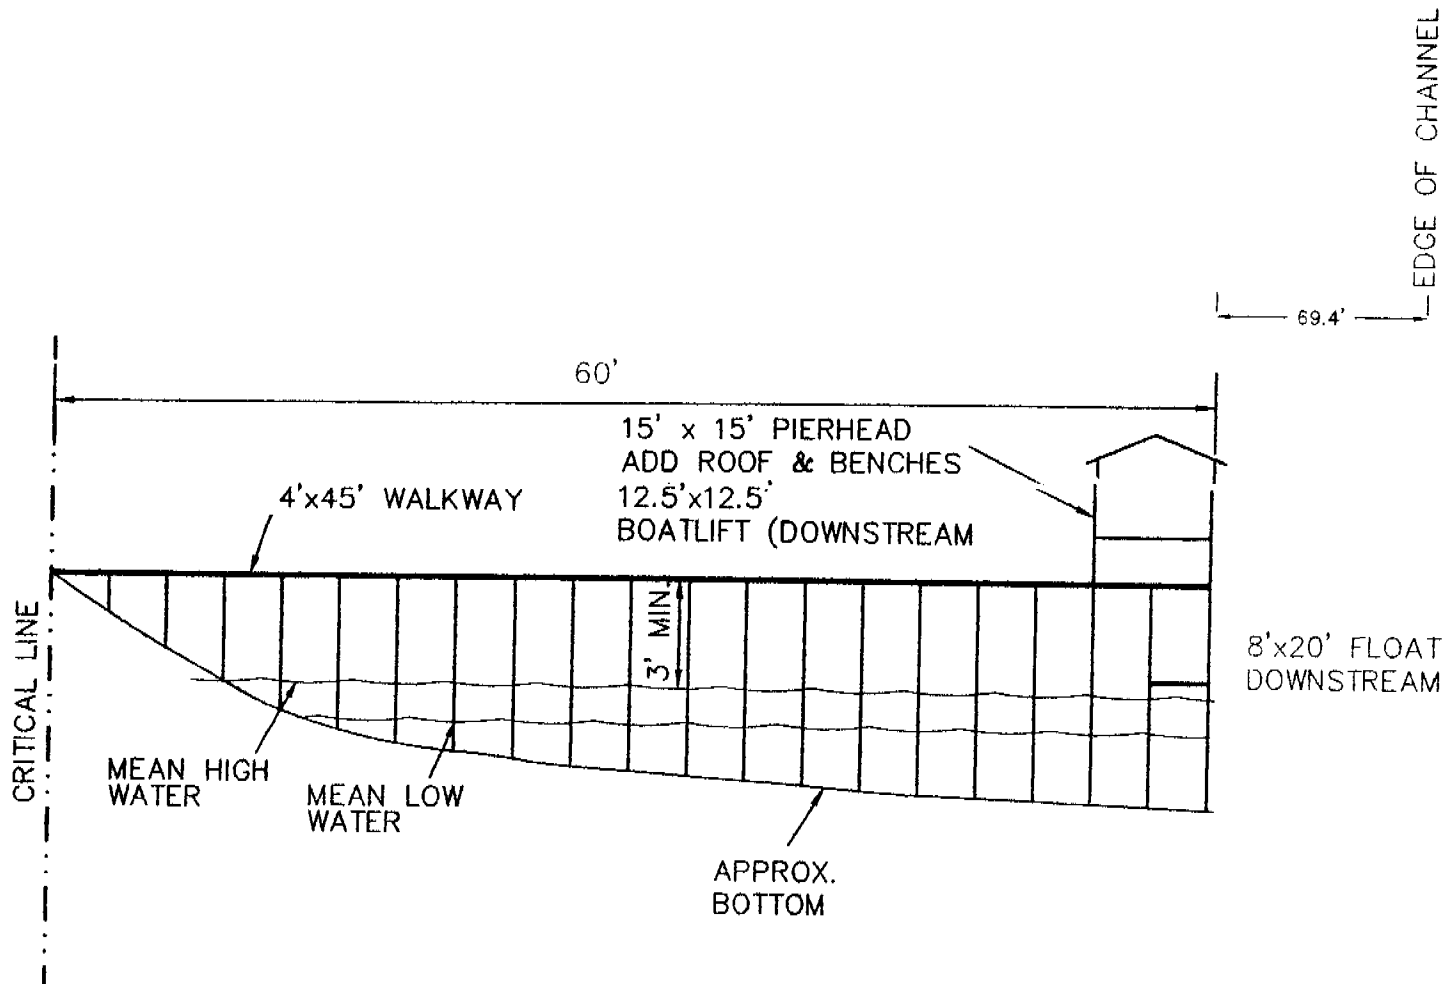

OCR-05-243-R


APPLICANT: VINCENT BROWN
#3 CONQUEST AVENUE
SULLIVANS ISLAND
CHARLESTON COUNTY
TMS#523-06-00-029
INTRACOASTAL WATERWAY

AMENDMENT
PRIVATE
RECREATIONAL
DOCK

DATE: MARCH 17, 2008

NO SCALE

FILE #184-05

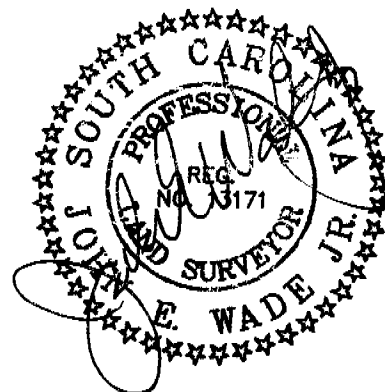




Charleston County, South Carolina

Copyright 2004
Charleston County GIS
4045 Bridge View Drive
North Charleston, SC 29405-7464

Legend Selected Features

Streets/Roads

☐ Parcels

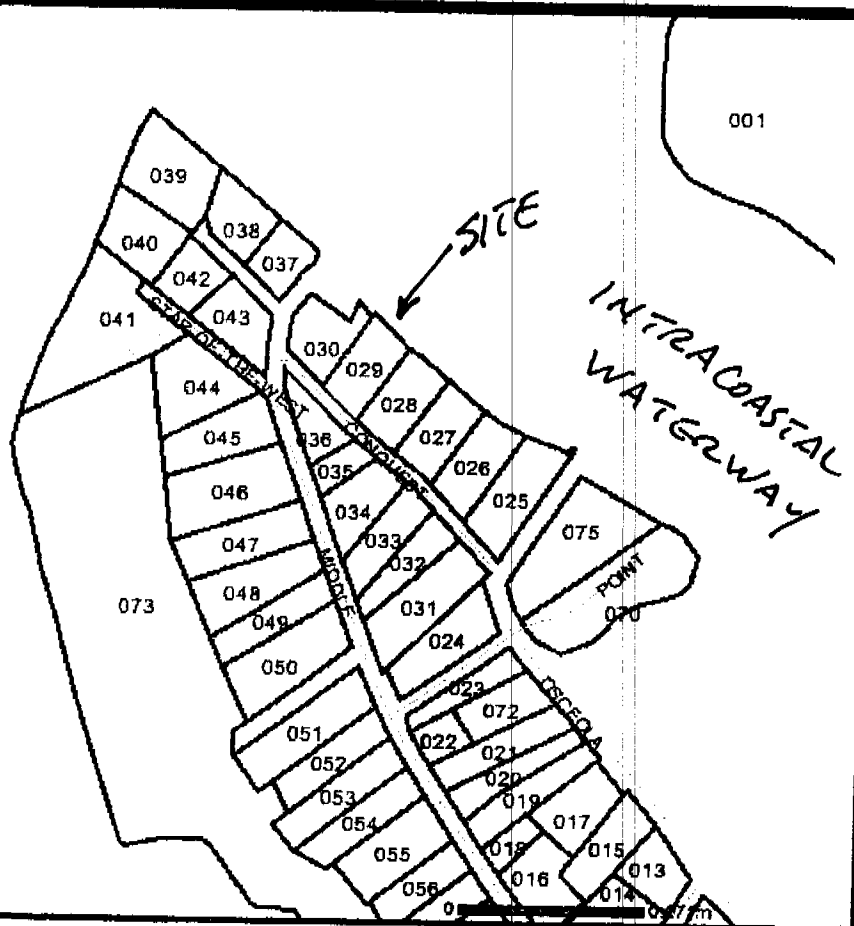

PARCEL NUMBER : 5230600029

PARCEL ID: 5230600029

STREET NUMBER: 814

STREET NAME: CONQUEST AVE

PROP UNIT:

PROP CITY:

PROP ZIP: 29482

SITE NAME:

GENERAL USE: SFR

SUBDIVISION:

LEGAL DESCRIPTION: LT 3 WHARF SITE

LGL HI ACRES: 0

**SEE SPECIAL
CONDITIONS(S)**

APPLICANT: VINCENT BROWN
#3 CONQUEST AVENUE
SULLIVANS ISLAND
CHARLESTON COUNTY
TMS#523-06-00-029
INTRACOASTAL WATERWAY

PRIVATE
RECREATIONAL
DOCK

DATE: AUGUST 4, 2005

NO SCALE

OCRM-05-243-R

FILE #184-05

ceName=Charl... 8/4/2005